



EXISTING SITE PLAN
SCALE 1:200

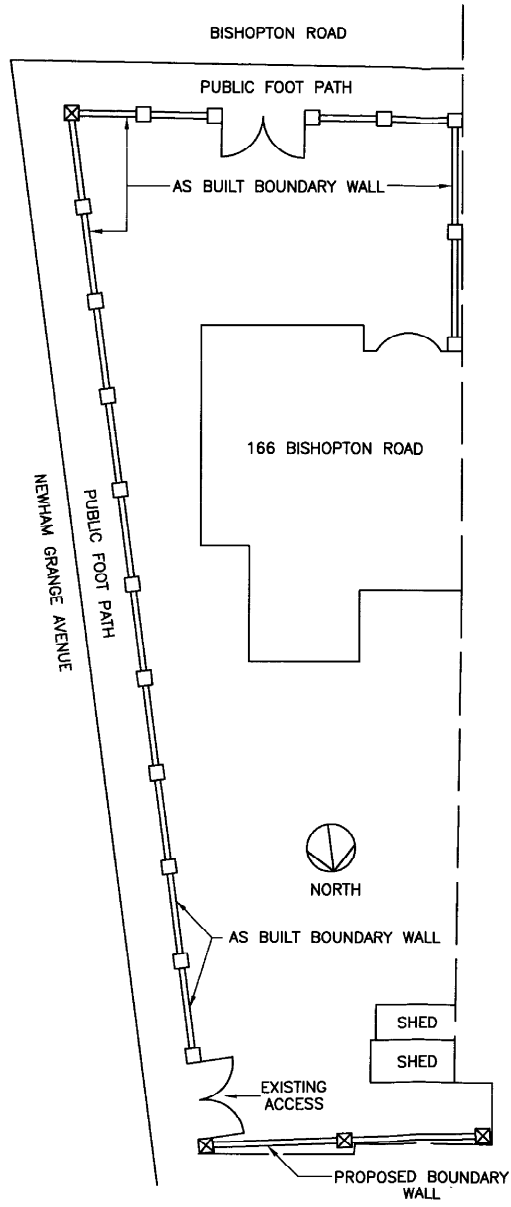

AS BUILT/PROPOSED SITE PLAN
SCALE 1:200

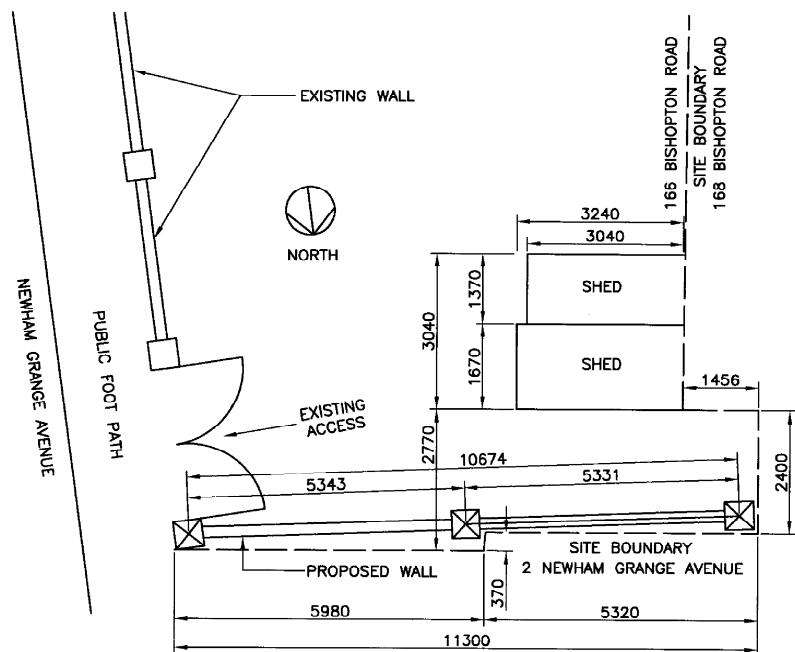

PART SITE PLAN
SCALE 1:100

NOTE:
VERY THICK VEGETATION GROWTH TO
THE REAR OF GARAGE AND SHEDS
ON BOTH SIDES OF THE BOUNDARY

Received 29/3/10

AS BUILT/PROPOSED
BOUNDARY WALL

MR & MRS KHAN
166 BISHOPTON ROAD,
STOCKTON ON TEES.
TS18 4PQ

DRAWING No./CAD FILE
2010/001/01

B									
SCALE	1:100 1:200 ● A3				DATE	24 MARCH 10			

P.D.S.

PROFESSIONAL DRAWING SERVICE

DRAWN BY	C.B.	CHECKED		SIG.	
----------	------	---------	--	------	--

